


PLACEMENT OF ALL INSULATED JOINTS AND MEASUREMENTS ARE ALL TO BE CONFIRMED IN FIELD

ALL SERVICE LOCATIONS & CAPACITIES TO BE PROVIDED ALL BUNGLAOW LOCATIONS TO BE PROVIDED


ALL TRACK POLARITIES TO BE PROVIDED AND CONFIRMED BY THE FIELD ALL TRACK NAMES TO BE CONFIRMED OR PROVIDED BY THE FIELD

ALL WAYSIDE EQUIPMENT NOT SHOWN TO BE PROVIDED

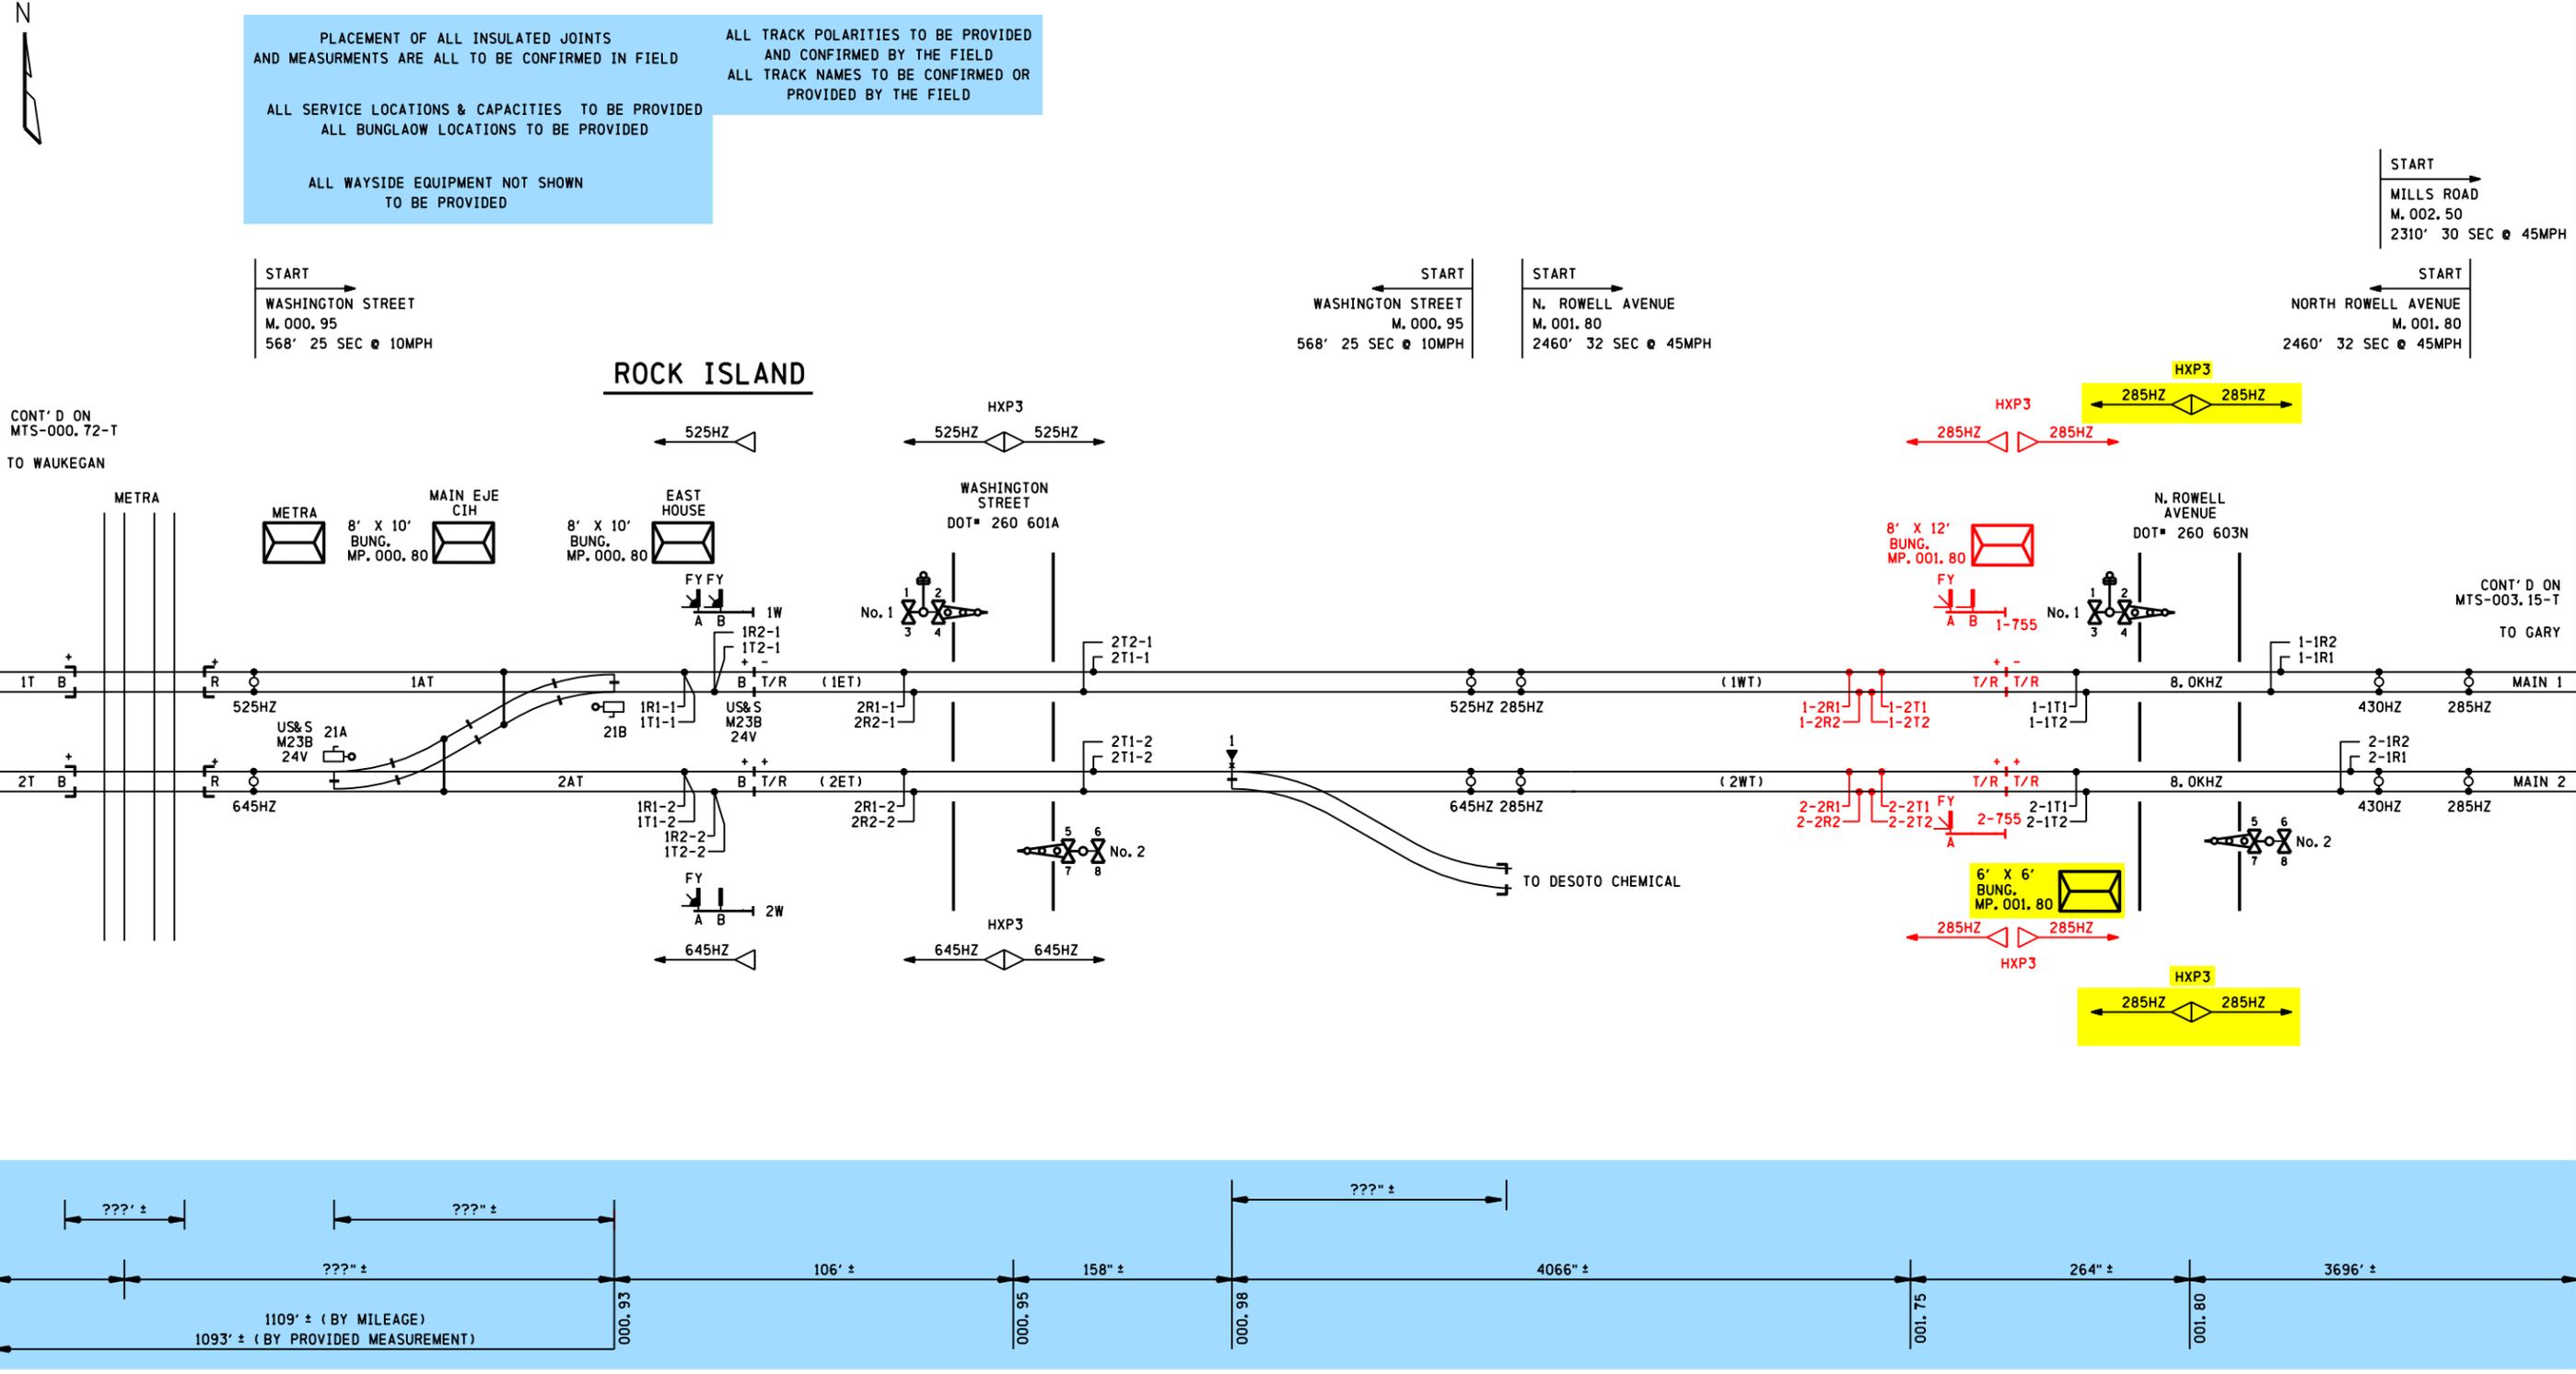

CONT'D ON
MTS-000.72-T
TO WAUKEGAN

CONT'D ON
MTS-003.15-T
TO GARY

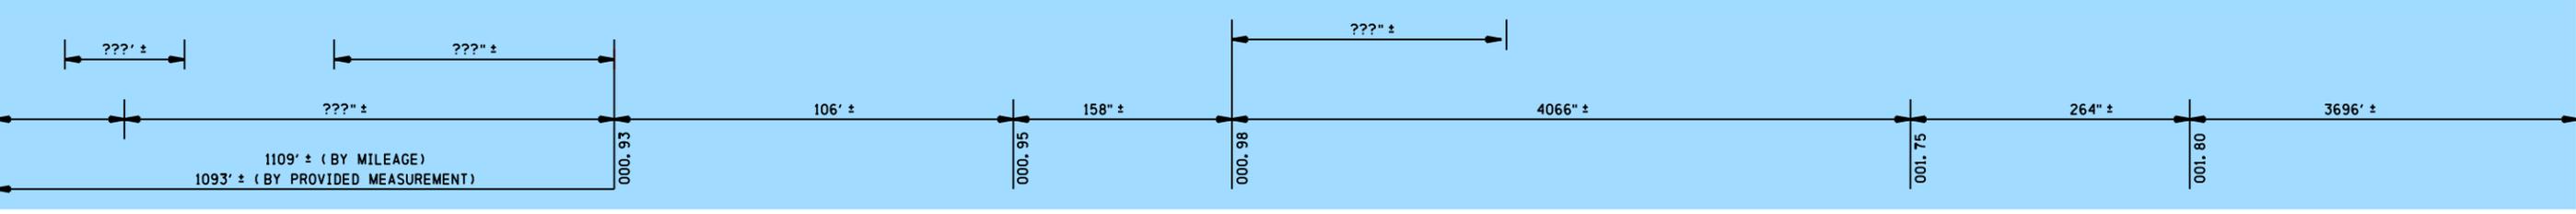

TO BE CONFIRMED

CONFIRMED

DATE _____

BY _____

(PRINT NAME)

PROPOSED

DESIGN NO. 11-0279

RED-IN YELLOW-OUT

AS INSTALLED

DATE _____

BY _____

(PRINT NAME)

PROPOSED			COMPLETED		
D	M	Y	D	M	Y
17	11	11			
30	11	11			

REGION SOUTHERN		CN
SUB. MATTESSON 334		
SIGNALS AND COMMUNICATIONS HOMWOOD		DES. DPC
22 DECEMBER 2010		CH. GGS
MILE 001.80 TO MILE 000.80		
EAST JOLIET		
MTS-001.80-T		