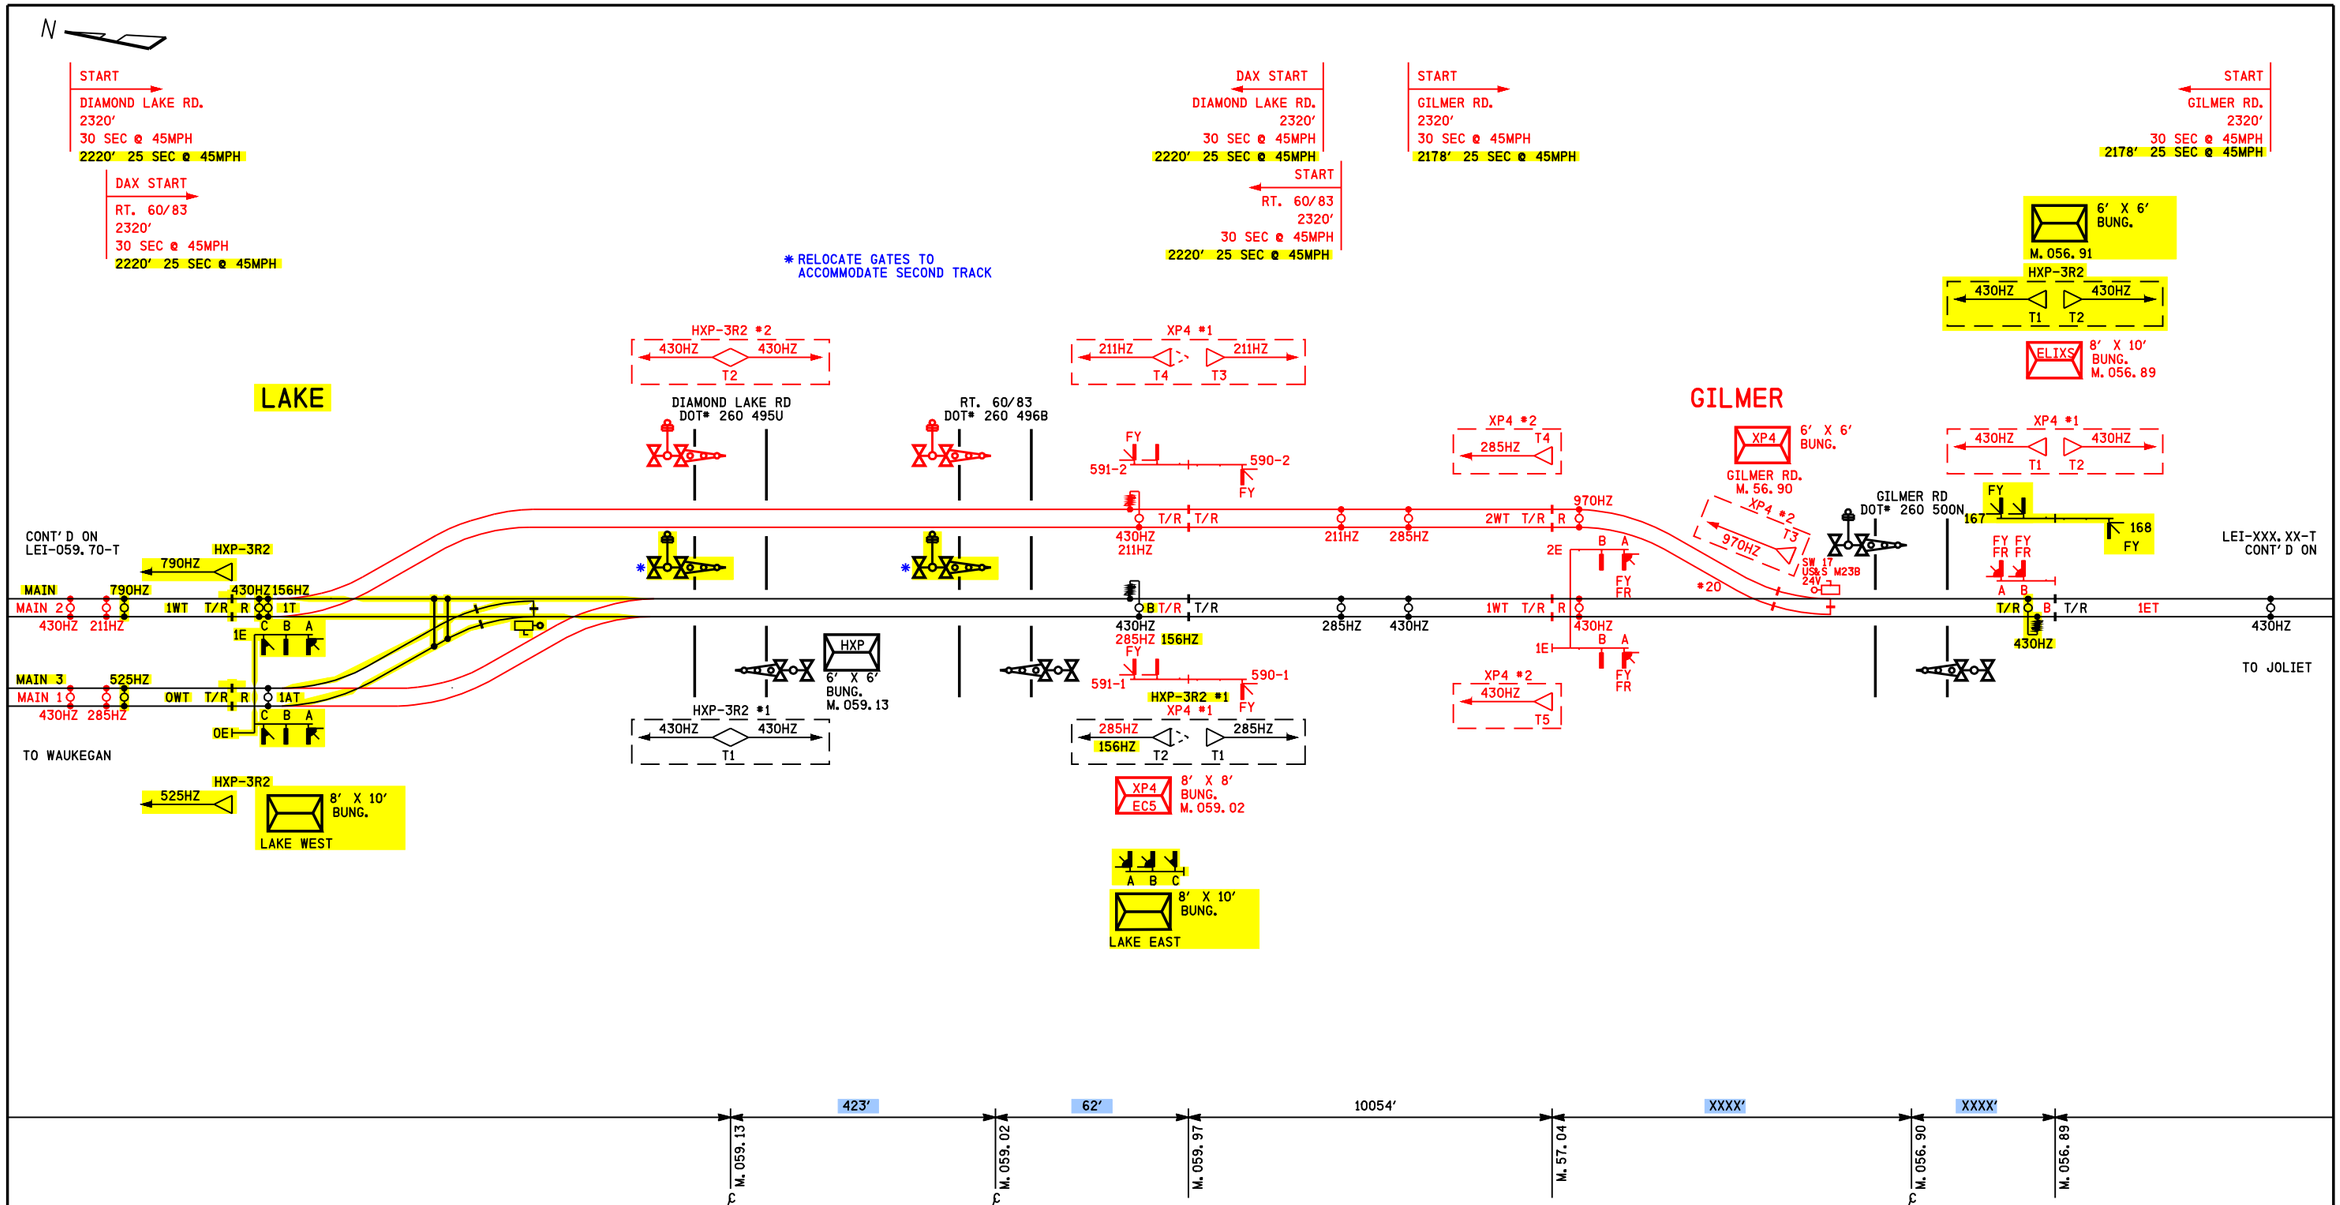


FIELD TO VERIFY

PROPOSED
DESIGN NO. 12-0019
RED-IN YELLOW-OUT

AS INSTALLED
DATE _____
BY _____
(PRINT NAME)

| PROPOSED D | M | Y | REVISIONS | D | C | COMPLETED D | M | Y | C |
|---|---|---|---|---|---|---|---|---|---|
| | | | | | | | | | |

REGION SOUTHERN
SUB. LEITHTON 332

SIGNALS AND COMMUNICATIONS HOMEWOOD
JANUARY 16, 2012
DES. JLW
CH. CDW

TRACK PLAN

GILMER

LEI-056.89-T

lei-056.89 -T.dgn
14-JUN-2012