REVISIONS				
NO.	DATE	BY	DESCRIPTION	APP. BY
1				
2				
3				
4				
5				

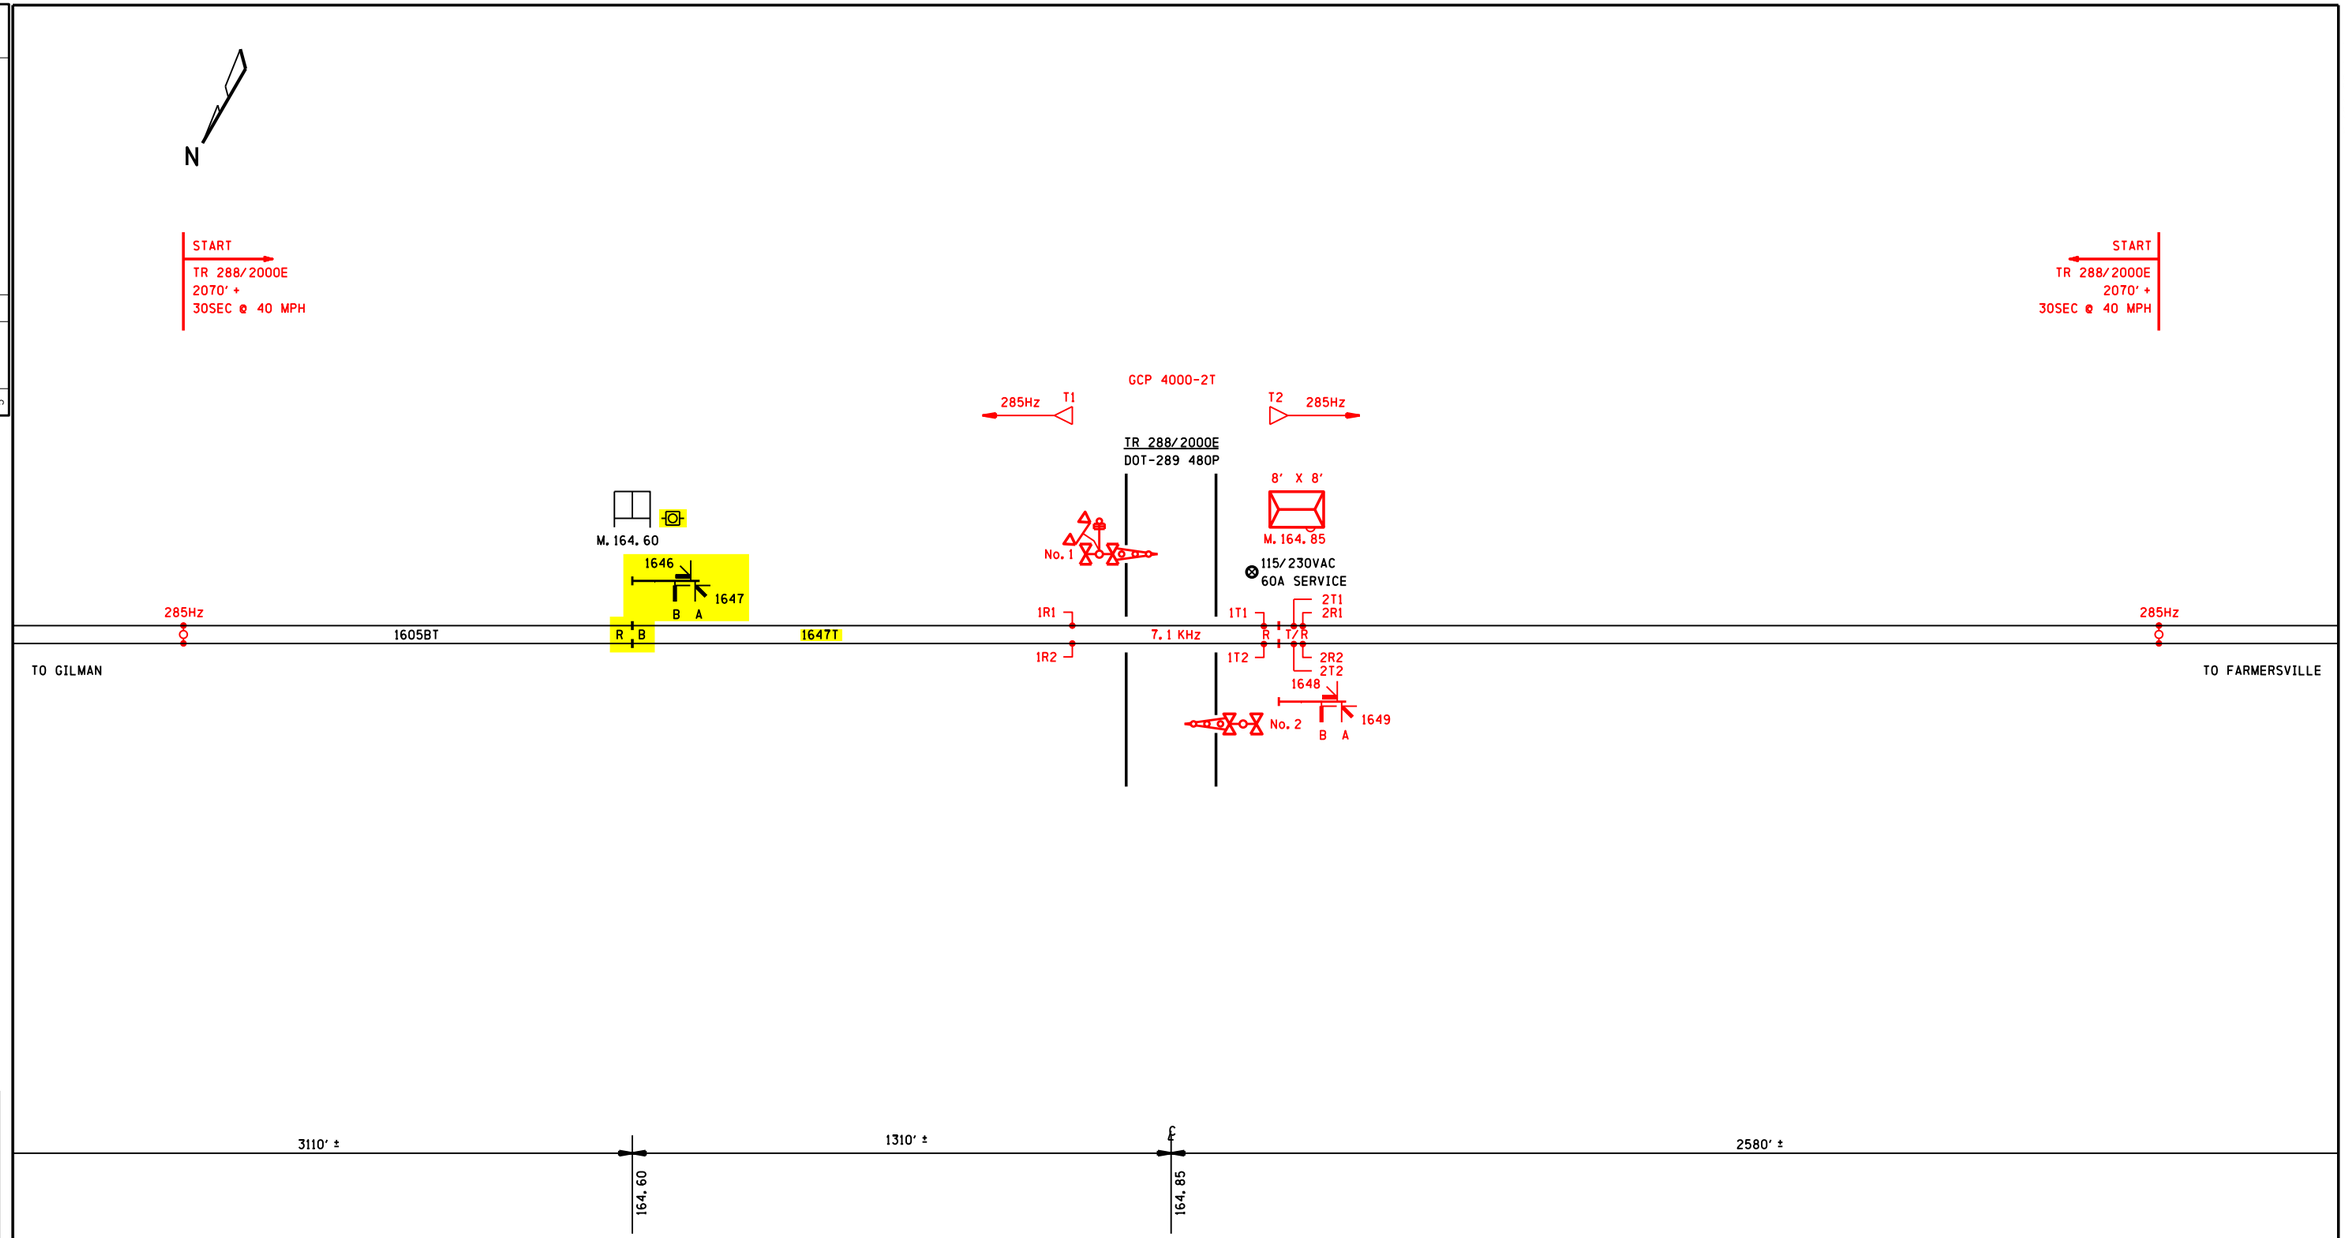

NOTE

DENOTES MULTI-FREQ. NARROW BAND SHUNT #62775-1543

IRC 22 OCT 2013

PROPOSED

DESIGN NO. 12-0121

RED-IN YELLOW-OUT

AS INSTALLED

DATE _____

BY _____

(PRINT NAME)

PROPOSED D	PROPOSED M	PROPOSED Y	REVISIONS	D	C	COMPLETED D	COMPLETED M	COMPLETED Y	C
22	10	13	PROP XING M.164.85	KLT	BJW				

REGION SOUTHERN

SUB. GILMAN 349

SIGNALS AND COMMUNICATIONS HOMEWOOD

DES. KLT

22 OCTOBER 2013

CH. BJW

TRACK PLAN
MILE 164.60 TO MILE 164.85

GIL-164.60-T

INVENSYS RAIL CORPORATION

DES.: KLT	DATE: 10/22/13	JOB NO.: PICA10413	
CKD.: BJW	ISSUE DATE: N/A	EST. NO.: XP-6593	
DRN.: KLT	PLAN NO.: N/A	SHEET N/A OF N/A	
P TIME: 11:45	P DATE: $$PLOT_DATE	CAD ID.: GIL-164.60-T	

INVENSYS RAIL CORP.
LOUISVILLE DIVISION, LOUISVILLE, KY

gil-164.60-t.dgn
23-JAN-2014