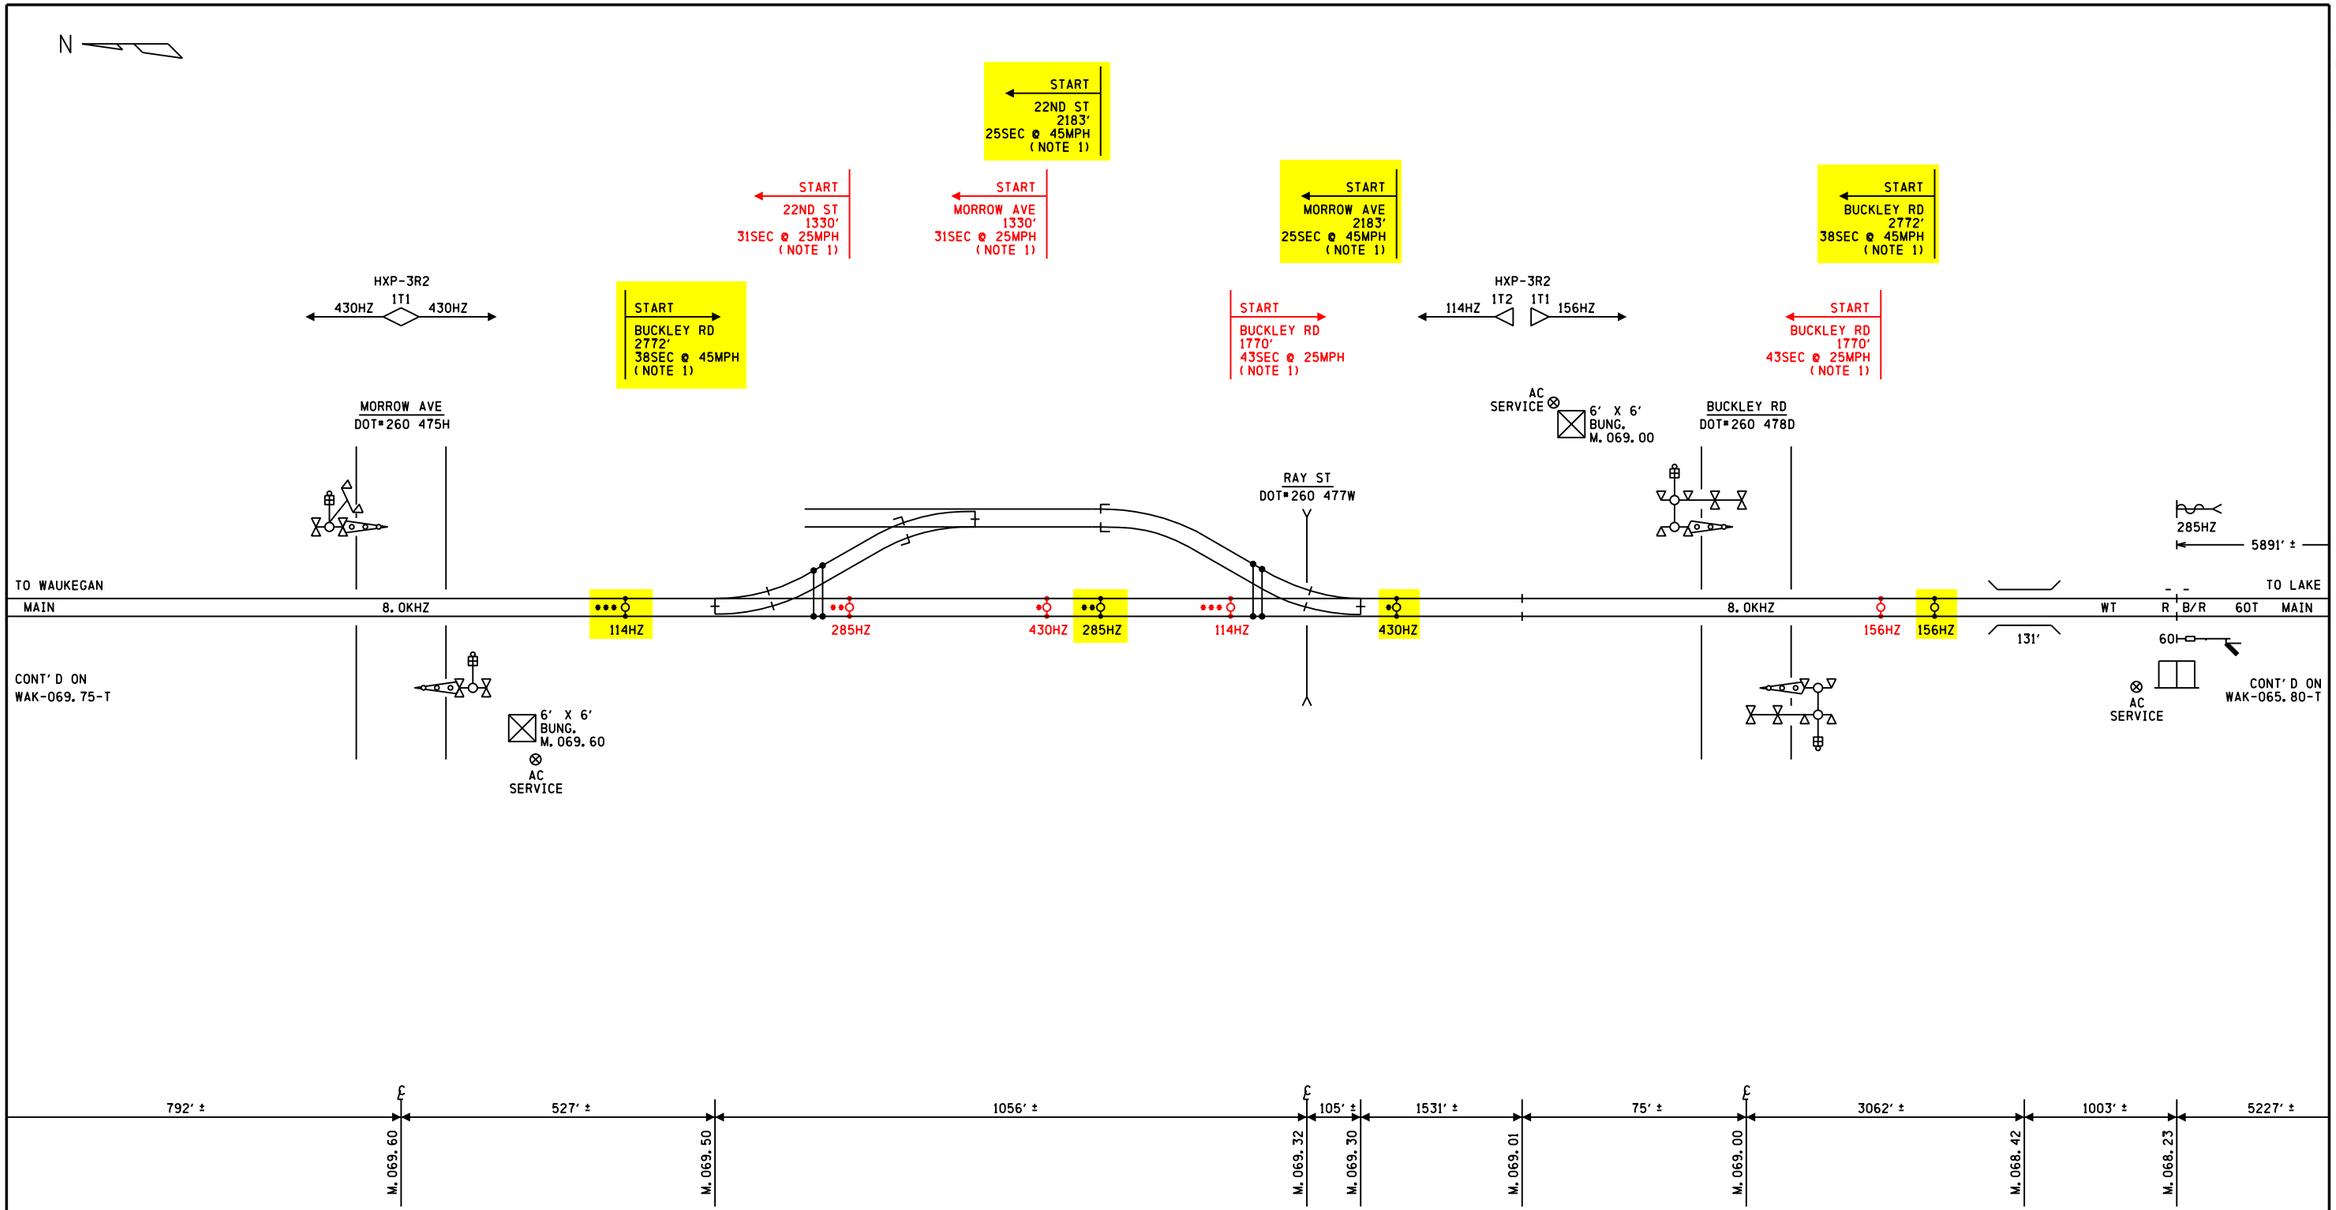

NOTES

1) APPROACH DISTANCE MEASURED FROM TRACK LEADS

DENOTES NARROW-BAND SHUNT #62775-156

DENOTES NARROW-BAND SHUNT #62775-430

DENOTES NARROW-BAND SHUNT #62775-285

DENOTES NARROW-BAND SHUNT #62775-114

FIELD TO CONFIRM ALL DETAILS

TO BE CONFIRMED

CONFIRMED

DATE _____

BY _____

(PRINT NAME)

PROPOSED

DESIGN NO. 14-0254

RED-IN YELLOW-OUT

AS INSTALLED

DATE _____

BY _____

(PRINT NAME)

PROPOSED D	PROPOSED M	PROPOSED Y	REVISIONS	D	C	COMPLETED D	COMPLETED M	COMPLETED Y	C
			PLAN REDRAWN			27	10	14	JBF
27	10	14	APP CHANGE FOR 25MPH	JBF	TPF				

REGION SOUTHERN

SUB. WAUKEGAN 322

SIGNALS AND COMMUNICATIONS HOMEWOOD

19 MAY 1997

DES. CEM

CH. RAS

TRACK PLAN
M.068.23 TO M.069.60

WAK-068.23-T

wak-068.23-t.dgn
23-DEC-2014