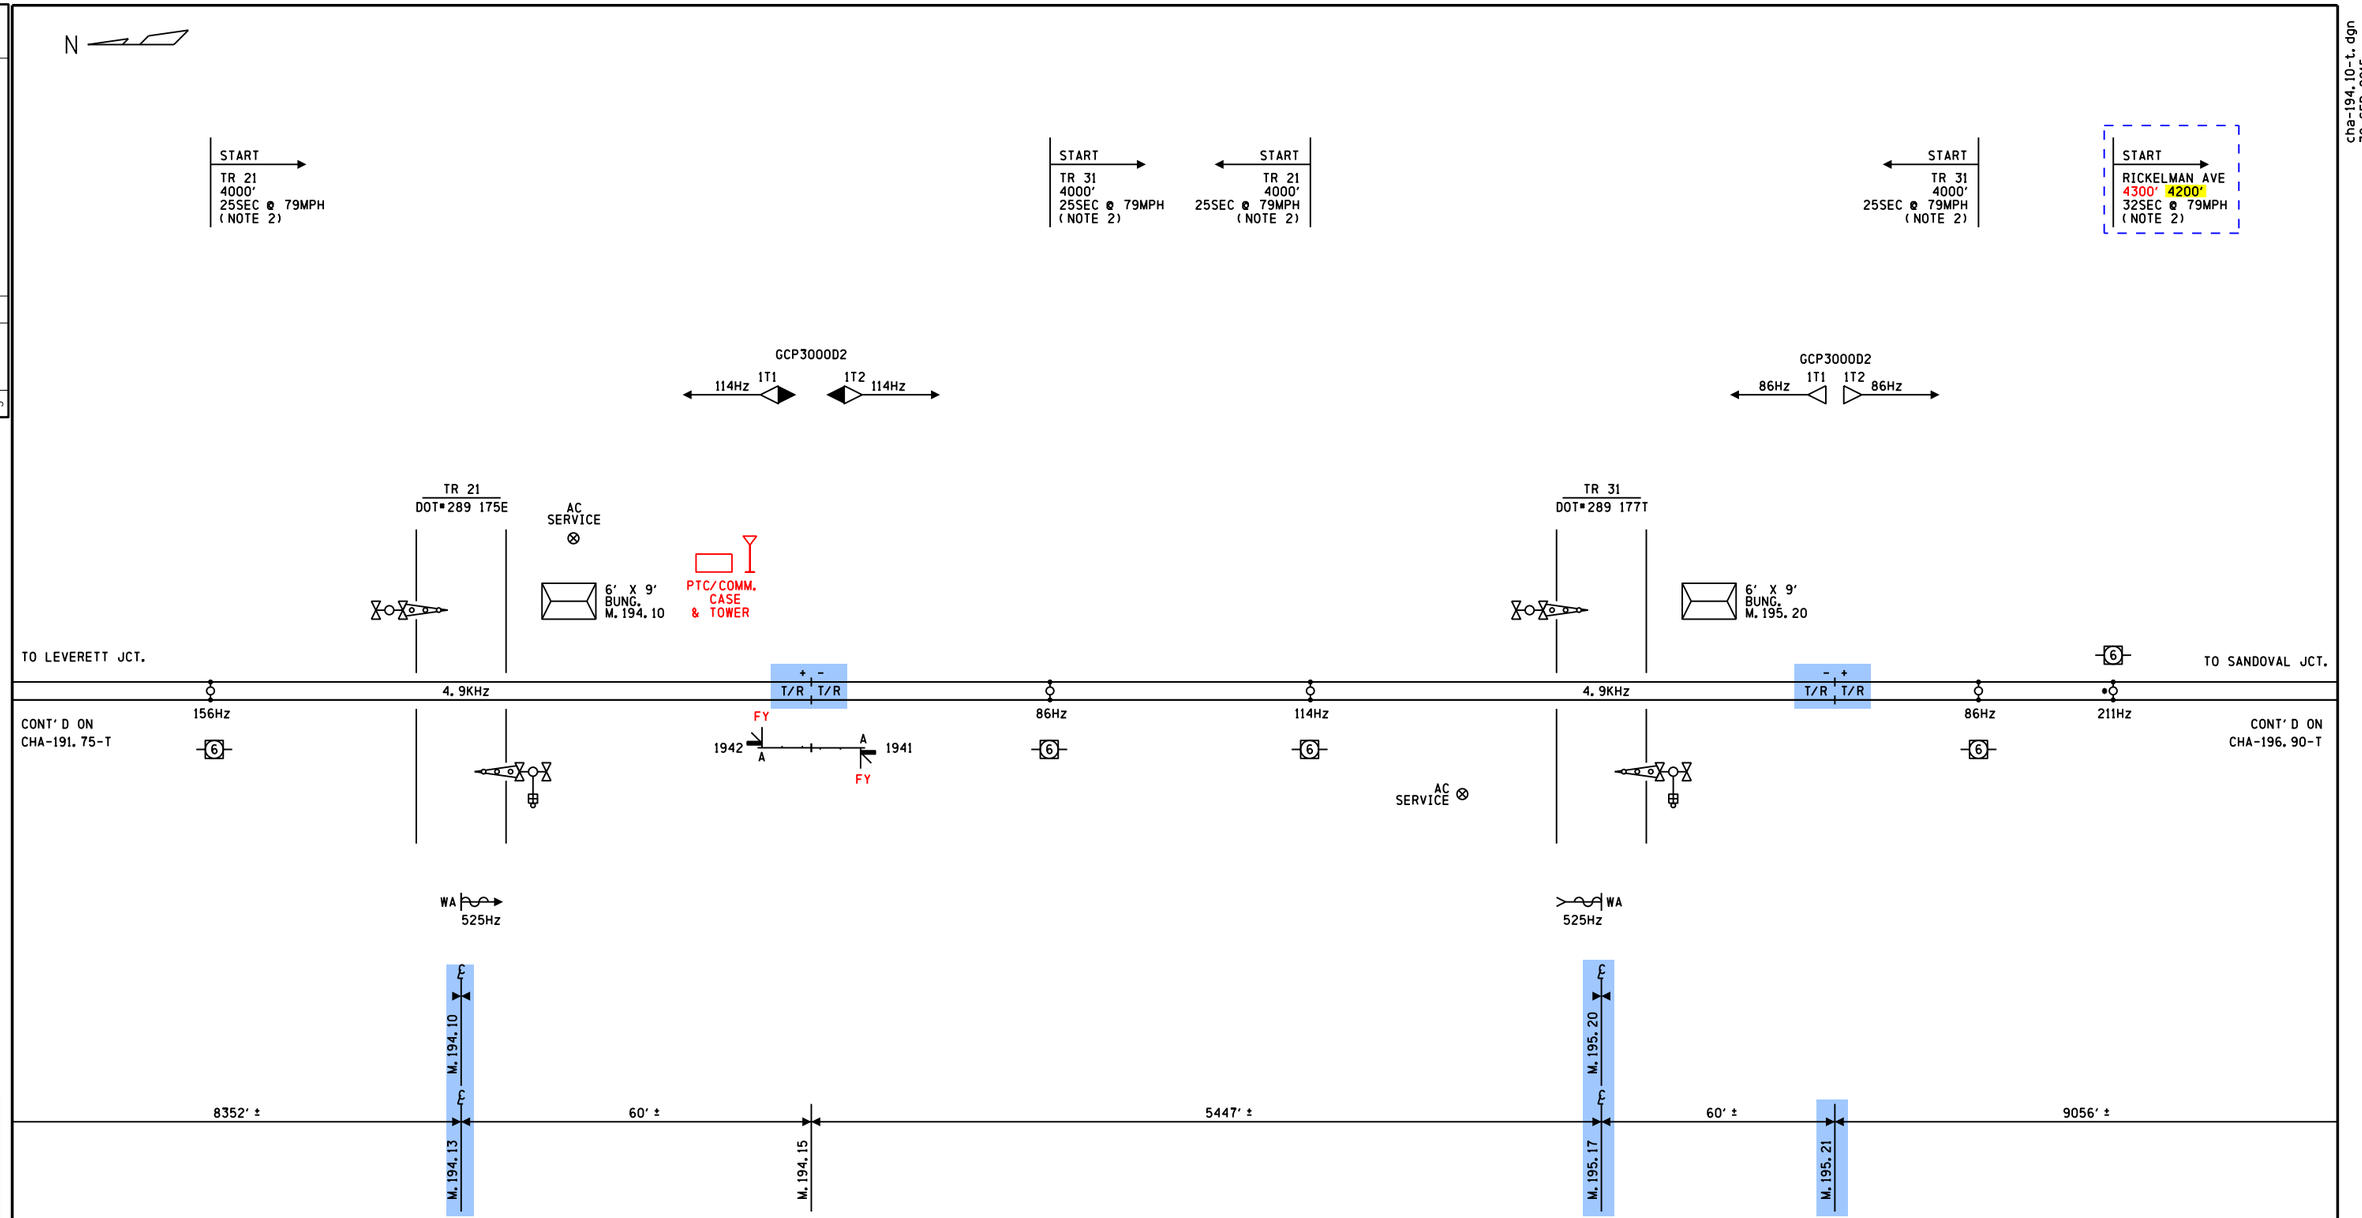

NOTES

1) HIGHWAY CROSSING TRACK CONNECTIONS TO BE 4 WIRE UNLESS NOTED WITH * IN TRACK CIRCUIT, THEN 6 WIRE SEE LOCATION PLAN FOR TRACK WIRING

2) APPROACH DISTANCE MEASURED FROM TRACK LEADS

DENOTES MULTIFREQUENCY NARROW-BAND SHUNT #62775-8621

*DENOTES MULTIFREQUENCY NARROW-BAND SHUNT #62775-1543

SII 13 MAR 2014

DENOTES PROPOSAL 15-0213 REVISION 29/07/15

TO BE CONFIRMED

CONFIRMED
DATE _____
BY _____
(PRINT NAME)

PROPOSED
DESIGN NO. PTC-003
RED-IN YELLOW-OUT

AS INSTALLED
DATE _____
BY _____
(PRINT NAME)

PROPOSED
DESIGN NO. 15-0213
RED-IN YELLOW-OUT

AS INSTALLED
DATE _____
BY _____
(PRINT NAME)

PROPOSED D	M	Y	REVISIONS	D	C	COMPLETED D	M	Y	C
			PLAN REDRAWN			13	03	14	LSS
			FIELD CHECK			22	07	15	JBF
13	03	14	PTC UPGRADE	LSS	SIA				
29	07	15	M.196.80 XR CHANGE	JBF	TPF				

REGION SOUTHERN
SUB. CHAMPAIGN 341
SIGNALS AND COMMUNICATIONS HOMEWOOD
30 SEPTEMBER 2004
DES.
CH.
TRACK PLAN
M.194.10 TO M.195.21

CHA-194.10-T

REVISIONS			
NO.	DATE	BY	DESCRIPTION	APP. BY
1				
2				
3				
4				
5				

SIEMENS INDUSTRY INC
DES.: LSS
CKD.: SIA
DRN.: LSS
P TIME:14:08
DATE: 03/13/14
ISSUE DATE: N/A
PLAN NO.:N/A
P DATE: $$PLOT_DATE
JOB NO.: JXXE04655
EST. NO.:QDE000258
SHEET 1 OF 1
CAD ID.: CHA-194.10-T

cha-194.10-t.dgn
30-SEP-2015

SIEMENS INDUSTRY INC
LOUISVILLE DIVISION, LOUISVILLE, KY

REVISIONS				
NO.	DATE	BY	DESCRIPTION	APP. BY
1				
2				
3				
4				
5				

cha-196.90-t.dgn
06-AUG-2015

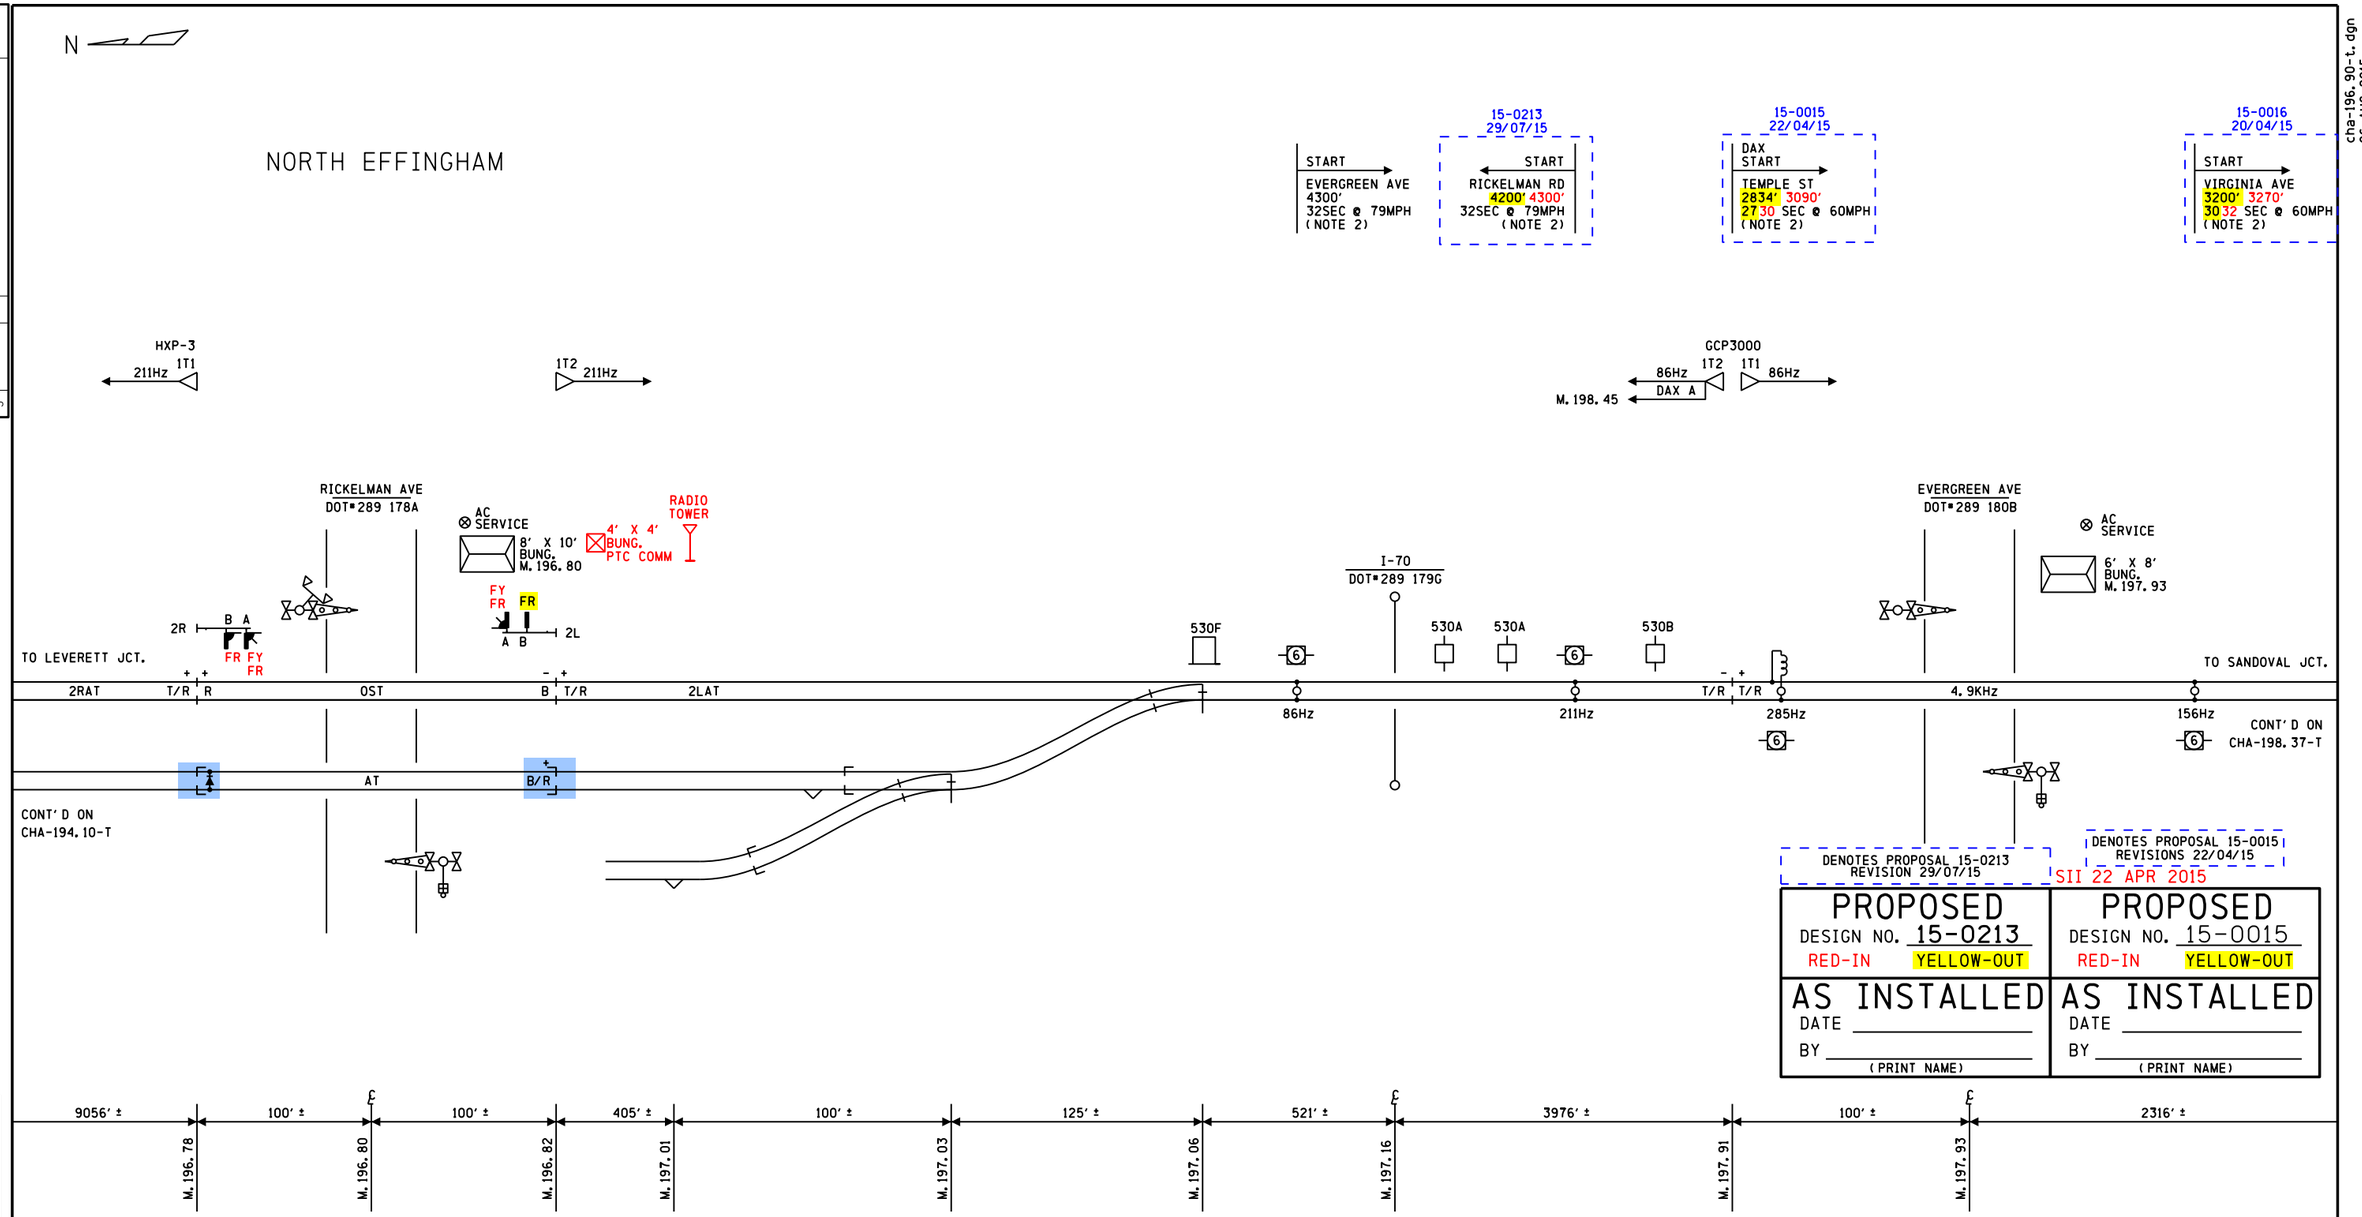

NOTES

1) HIGHWAY CROSSING TRACK CONNECTIONS TO BE 4 WIRE UNLESS NOTED WITH * IN TRACK CIRCUIT, THEN 6 WIRE SEE LOCATION PLAN FOR TRACK WIRING

2) APPROACH DISTANCE MEASURED FROM TRACK LEADS

DENOTES MULTIFREQUENCY NARROW-BAND SHUNT #62775-8621

DENOTES MULTIFREQUENCY NARROW-BAND SHUNT #62775-1543 WITH SIMULATED TRACK INDUCTOR 8V617-1000

DENOTES RING 10 RECTIFIER

DENOTES PROPOSAL 15-0016
REVISIONS 20/04/15

SII 20 APR 2015

TO BE CONFIRMED

CONFIRMED
DATE
BY
(PRINT NAME)

PROPOSED
DESIGN NO. 15-0016
RED-IN YELLOW-OUT
AS INSTALLED
DATE
BY
(PRINT NAME)

SII 13 MAR 2014

PROPOSED
DESIGN NO. PTC-003
RED-IN YELLOW-OUT
AS INSTALLED
DATE
BY
(PRINT NAME)

PROPOSED D	PROPOSED M	PROPOSED Y	REVISIONS	D	C	COMPLETED D	COMPLETED M	COMPLETED Y	C
			PLAN REDRAWN			13	03	14	LSS
			FIELD CHECK			22	07	15	JBF
13	03	14	PTC UPGRADE	LSS	STA				
20	04	15	M.198.60 SSCCIV UPGRADE	JCM	BJW				
22	04	15	M.198.45 SSCCIV UPGRADE	APL	BJW				
29	07	15	M.196.80 XR CHANGE	JBF	TPF				

REGION SOUTHERN
SUB. CHAMPAIGN 341

SIGNALS AND COMMUNICATIONS HOMEWOOD
05 FEBRUARY 2001
DES.
CH.

TRACK PLAN
M.196.90 TO M.197.93

CHA-196.90-T

SIEMENS INDUSTRY INC
DES.: LSS
CKD.: SIA
DRN.: LSS
P TIME:14:28
DATE: 03/13/14
ISSUE DATE: N/A
PLAN NO.: N/A
P DATE: $$PLOT_DATE
JOB NO.: JXXE04655
EST. NO.: 0DE000258
SHEET 1 OF 1
CAD ID.: CHA-196.90-T

SIEMENS INDUSTRY INC
LOUISVILLE DIVISION, LOUISVILLE, KY