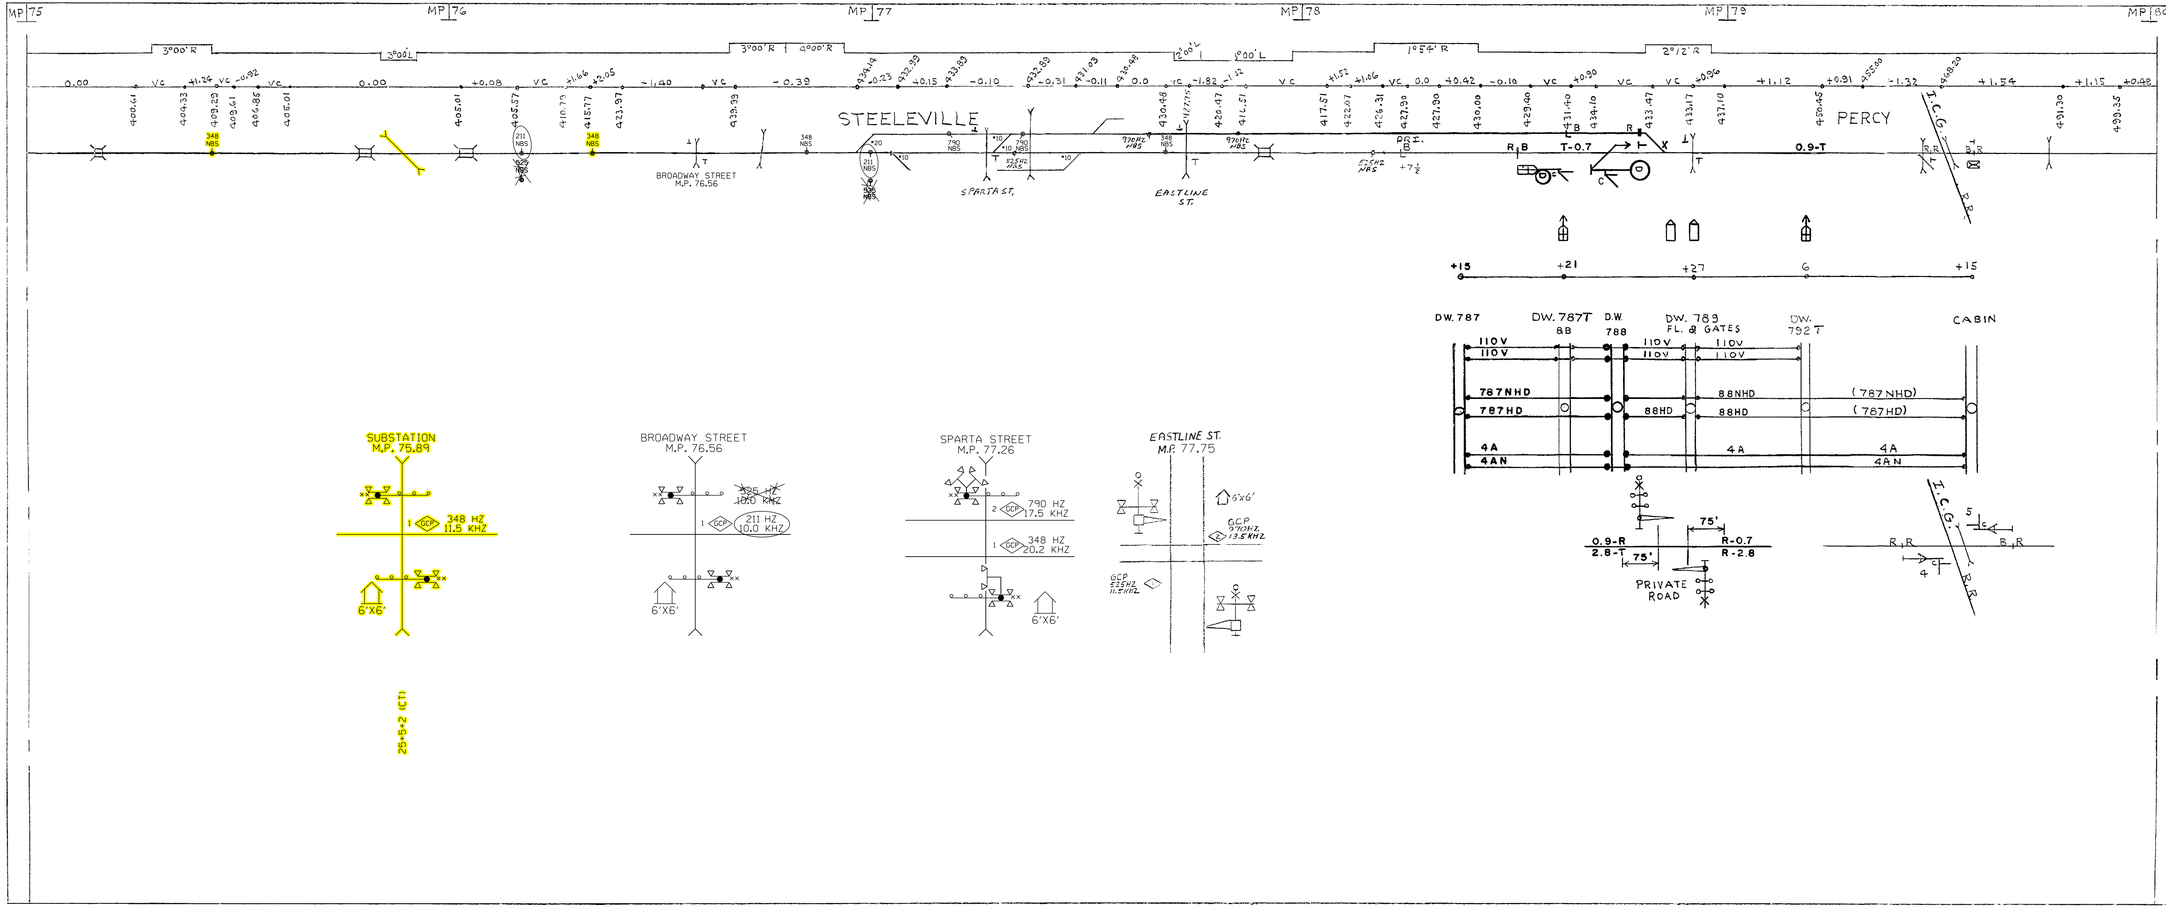

REV 9-8-58 ACCT. OPERATING SECTION EXTENDED 9-18-58 m	REV. 4-18-57 ACCT. OPERATING SECTION EXTENDED 4-22-57 HAS	REV. 8-14-56 ACCT. PL. & GATES ADDED AT PRIVATE ROAD 12-17-56 H.A.S.
REV. 1-16-76 D MARKER ADDED AT SIG. 787. 10-10-75 L.W.C. E.L.T.	REV. 1-16-76 RIBBON RAIL 4-4-74 L.W.C. E.L.T.	REV. 1-5-59 INOPERATIVE APP. SIG. MADE OPERATIVE 10-26-61 RHB m
REV. 11-7-02 INSTALLED CETI W.O. 5327 REC# 1234 7-11-02 JWJ/WITT/NST/EML	REV. 12-21-77 GATES ADDED AT SPARTA, ST. 4-18-77 E.R.T. S.F.B.	REV. 12-21-77 EXTEND SID. 9-10-76 E.R.T. S.F.B.
12 REV. 09-27-07 INSTALL FLS/GATES & CONST. AT SPARTA STREET M.P. 77.26 A.F.E. 888840 REC# 18424 08-08-07 RLT JEH/CTC/CTC/RDD	REV. 5-20-97 INSTALLED GATES & CLEARED AT EASTLINE ST. (M.P. 77.75) W.O.# 55360 REC# 19337 4-29-97 RLT JEH/WITT/HITTARD	REV. 8-17-05 INSTALLED FM10-2 @ 76.50 AND APP. DIST. FOR 77.2 REC# 13051 8-10-05 CAM/WITT
Designed: 02-09-15 INSTALL FLASHERS, GATES, AND CWT AT M.P. 75.89 SUBSTATION ROAD PID: 89578 WO#: 27765 Rec#: / JEH JJB	Revised: 10/21/13 CHANGED M.P.77.80 TO M.P.77.75 PER FIELD AC MARKUPS. Rec#: 19416 WO#: / 1st 6/24/13 / MJD/XRL / /	13 REV. 09-08-08 INSTALL FLS/GATES & CONSTANT WARNING AT BROADWAY STREET M.P. 76.56 A.F.E. 888839 REC# 18908 02-04-08 RLT JEH/CTC/CTC/RDD

WO 27765

: IN

= EXISTING
REVISE

TIF FILE ATTACHED TIF ID = 127675.5M.TIF

SH-9

UNION PACIFIC R.R. CO.
ILLINOIS DIV.
MT. VERNON JCT TO MT. VERNON
POLE LINE DIAGRAM
PINCKNEYVILLE SUBDIVISION

SCALE HOR. 1" = 1000'
VERT. 1" = 50

ST. LOUIS, MO. 8-14-56.
DRAWN BY H.A.S.
CHECKED
CORRECT

SIGNAL ENGINEER

S-1276-M